



पावरग्रिड
POWERGRID

पावर ग्रिड कॉर्पोरेशन ऑफ इंडिया लिमिटेड

(भारत सरकार का उद्यम)

POWER GRID CORPORATION OF INDIA LIMITED

(A Government of India Enterprise)

Ref: SR-II: RTI:F-1159:2020/ 2848

Date: 7th December, 2020

Smt. S.Rachana, Advocate
"Arunodaya Nilaya", B.L.Gowda Nagar,
Hiriyur Taluk, CHITRADURGA – 577599.

Madam,

Sub: Information sought under RTI Act, 2005 – reg.

This has reference to your application dated 02/11/2020 under RTI Act, 2005 received at this office on 09/11/2020. The query wise information sought in the application is furnished below:

Prior consent or prior permission is not stipulated in the Electricity Act, 2003 or The Indian Telegraph Act, 1885 and the same has been upheld by various Hon'ble High Courts and the Hon'ble Supreme Court of India.

- 1) Notice issued to Smt.Kathyayanamma/Smt. G.Saraswathi vide Notice No.1924 (Annex-A)
- 2) No. Compensation i.r.o. Sy.No.245/1 was awarded to Smt.Kathyayanamma.
- 3) No temporary injunction order passed against erection of line.
- 4) & 5) Refer reply to Q.No.1 above.
- 6) M/s KRRTPL engaged as contractor.
- 7) Furnished below.
- 8) Smt. M Vasanthi, Sr.DGM, Power Grid corporation of India Ltd, Hiriyur sub-station.
- 9) Crop damages awarded Rs.608378/- and Rs.324468/- for pomegranate compensation for 210 trees and 112 trees respectively.
- 10) No bunds are destructed & no road was formed.
- 11) POWERGRID has only "USER RIGHT" and 'No acquisition of land' is involved in the process of construction of transmission line/tower which comes under The Electricity Act, 2003 and Indian Telegraph Act, 1885.
- 12) 3 acre 9.25 guntas.
- 13) M/s KRRTPL engaged as contractor for erection of electric line.
- 14) & 15) Mahazar/Survey sketch enclosed as Annex-B
- 16) The Transmission Line was constructed under prior approval by the Ministry of Power, Government of India vide Ref.52/11(PGCIL)/2015-PSPA-II/142-143 dated 23/02/2016 under section 68(1) of Electricity Act, 2003.

As per section 19 of the Right to Information Act 2005, if required, you may file an appeal to the First Appellate Authority of the organisation within 30 days of the issue of this order. The address of the First Appellate Authority is given below:

Shri S.Ravi, Executive Director (SRTS-II)
Power Grid Corporation of India Ltd., Singanayakanahalli, Yelahanka Hobli, Bangalore 560 064.
e-mail : sr2edo@powergrid.co.in Tel.No.: 080-23093701

Thanking you,

Yours faithfully,

(V.RAJESH)

Sr.General Manager & CPIO

e-mail id: sr2cpio@powergrid.co.in Tel.No.: 080-23093711

Encl.: As above

Copy to: Appellate Authority, POWERGRID, SRTS-II, Bangalore - for kind information

दक्षिणी क्षेत्र पारेषण प्रणाली - II क्षेत्रीय मुख्यालय, आर.टी.ओ. ड्राइविंग टेस्ट ट्रैक के पास सिंहनायकनहल्ली, येलहंका होब्ली, बेंगलूरु - 560 064. दूरभाष : 080-23093700

Southern Region Transmission System - II RHQ., Near RTO Driving Test Track, Singanayakanahalli, Yelahanka Hobli, Bengaluru - 560 064. Phone : 080-23093700

केन्द्रीय कार्यालय : "सौदामिनी", प्लॉट नं.: 2, सेक्टर-29, गुरुग्राम-122001, (हरियाणा), दूरभाष 0124-2571700-719

Corporate Office : "Saudamini", Plot No. 2, Sector-29, Gurugram-122001, (Haryana) Tel. : 0124-2571700-719

पंजीकृत कार्यालय : बी -9, कुतुब इंस्टीट्यूशनल एरिया, कटवारिया सराय, नई दिल्ली - 110 016 दूरभाष : 011-26560112, 26560121, 26564812, 26564892, सीआईएन : L40101DL1989GOI038121

Registered Office : B-9, Qutab Institutional Area, Katwaria Sarai, New Delhi-110 016. Tel : 011-26560112, 26560121, 26564812, 26564892, CIN : L40101DL1989GOI038121

Website : www.powergridindia.com

POWERGRID CORPORATION OF INDIA LIMITED

(A Government of India Enterprises)

House no : 05, Tirumal Nilaya, Near Swamy Vivekananda College, Vijayanagara Layout,
Pavagada - 561 202, Tumkur Dist.,



NOTICE UNDER INDIAN TELEGRAPH ACT 1885

No : Comp /

No : 1924

P. Kalyanamma / K. Saraswathi
Methur Village, Hiriyur TG
Chitradurga Dist

Date : 12/6/2016

Sir / Madam,

Power Grid Corporation Of India Ltd, has been entrusted with the construction of Pavagada - Hiriyur 400 KV D/C Transmission Line by Government of India Vide its letter No : 52/11 (PGCIL) / 2015-PA-II/142-143 dated 23.02.2016.

In exercise of the powers under the Indian telegraph act 1885, Part - III section 10 to 19 conferred section 164 of the Indian Electricity act 2003, through the Gazette of India, extraordinary dated December 2003, notice is hereby given that the 400 KV Pavagada-Hiriyur D/C Transmission Line will pass through your property as described below which may cause damage to the standing crops and the trees within the Right of way are required to be cut. The crops damaged / trees cut may be taken over by your authorized representative. Reasonable compensation for the crops damaged / trees cut will be given as per the assessment of the Revenue / Horticulture / Forest Departments (Governments of Karnataka/Andhra Pradesh).

Name of the Owner: P. Kalyanamma / K. Saraswathi
Survey no: 2011
Name of the Village: Methur
Name of the Mandal / Tashil: Hiriyur
Name of the District: Chitradurga
List of Trees to be cut:

Section	Tree No.	Name of Tree / Crop	Approx Age	Girth & Height of the tree / Area of the Crop	Tree cut / Crop Damaged During (FDN/EREC/ ST. RG)	
50/0-50/1 -50/2	-	Corridor compensation should be paid for total extent of approx. 1.25 hectares as per DC order dtd. 20.12.2016. Received under protest.				

Received the Notice :

Signature: *[Handwritten Signature]*



Authorized representative.

For : POWERGRID CORPORATION OF INDIA LIMITED

[Handwritten Signature]
CHARL RARU VAKANA
SENIOR ENGINEER
Signature

Metikurke

Chitradurga (D)
Hiriyur (T)

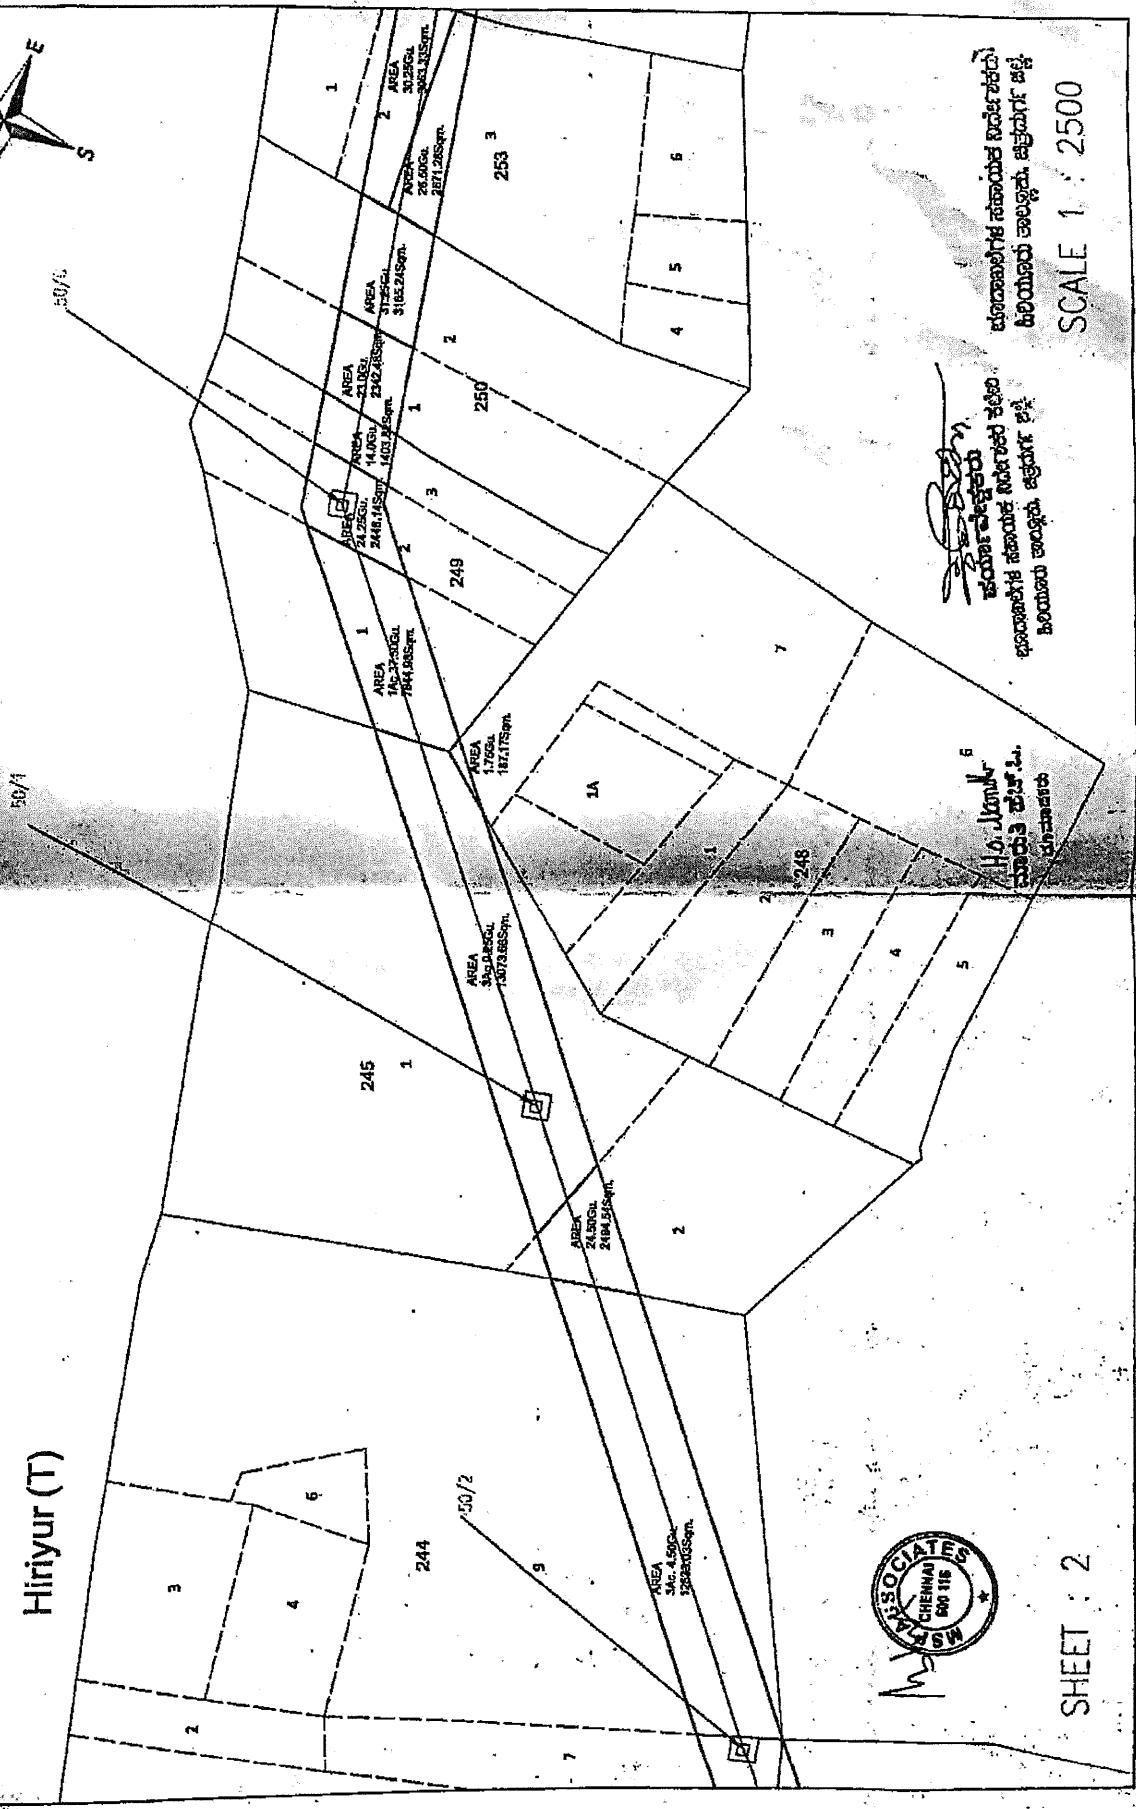
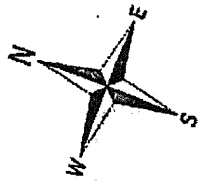


SHEET : 2

[Signature]
ಇಂತಿಮಾಹಿತಿಯು ಸರ್ಕಾರದ ಸಂಪತ್ತಾಗಿದೆ ಮತ್ತು ಅದರ ಬಳಕೆಗೆ ಮಾತ್ರವೇ ಸೀಮಿತವಾಗಿದೆ.
ಇತರರ ಅನುಮತಿ ಇಲ್ಲದೆ ಈ ದಾಖಲೆಯನ್ನು ಪ್ರಕಟಿಸಬಾರದು.

ಇಂತಿಮಾಹಿತಿಯು ಸರ್ಕಾರದ ಸಂಪತ್ತಾಗಿದೆ ಮತ್ತು ಅದರ ಬಳಕೆಗೆ ಮಾತ್ರವೇ ಸೀಮಿತವಾಗಿದೆ.
ಇತರರ ಅನುಮತಿ ಇಲ್ಲದೆ ಈ ದಾಖಲೆಯನ್ನು ಪ್ರಕಟಿಸಬಾರದು.
SCALE 1 : 2500

Metikurke Chitradurga (D) Hiriyur (T)

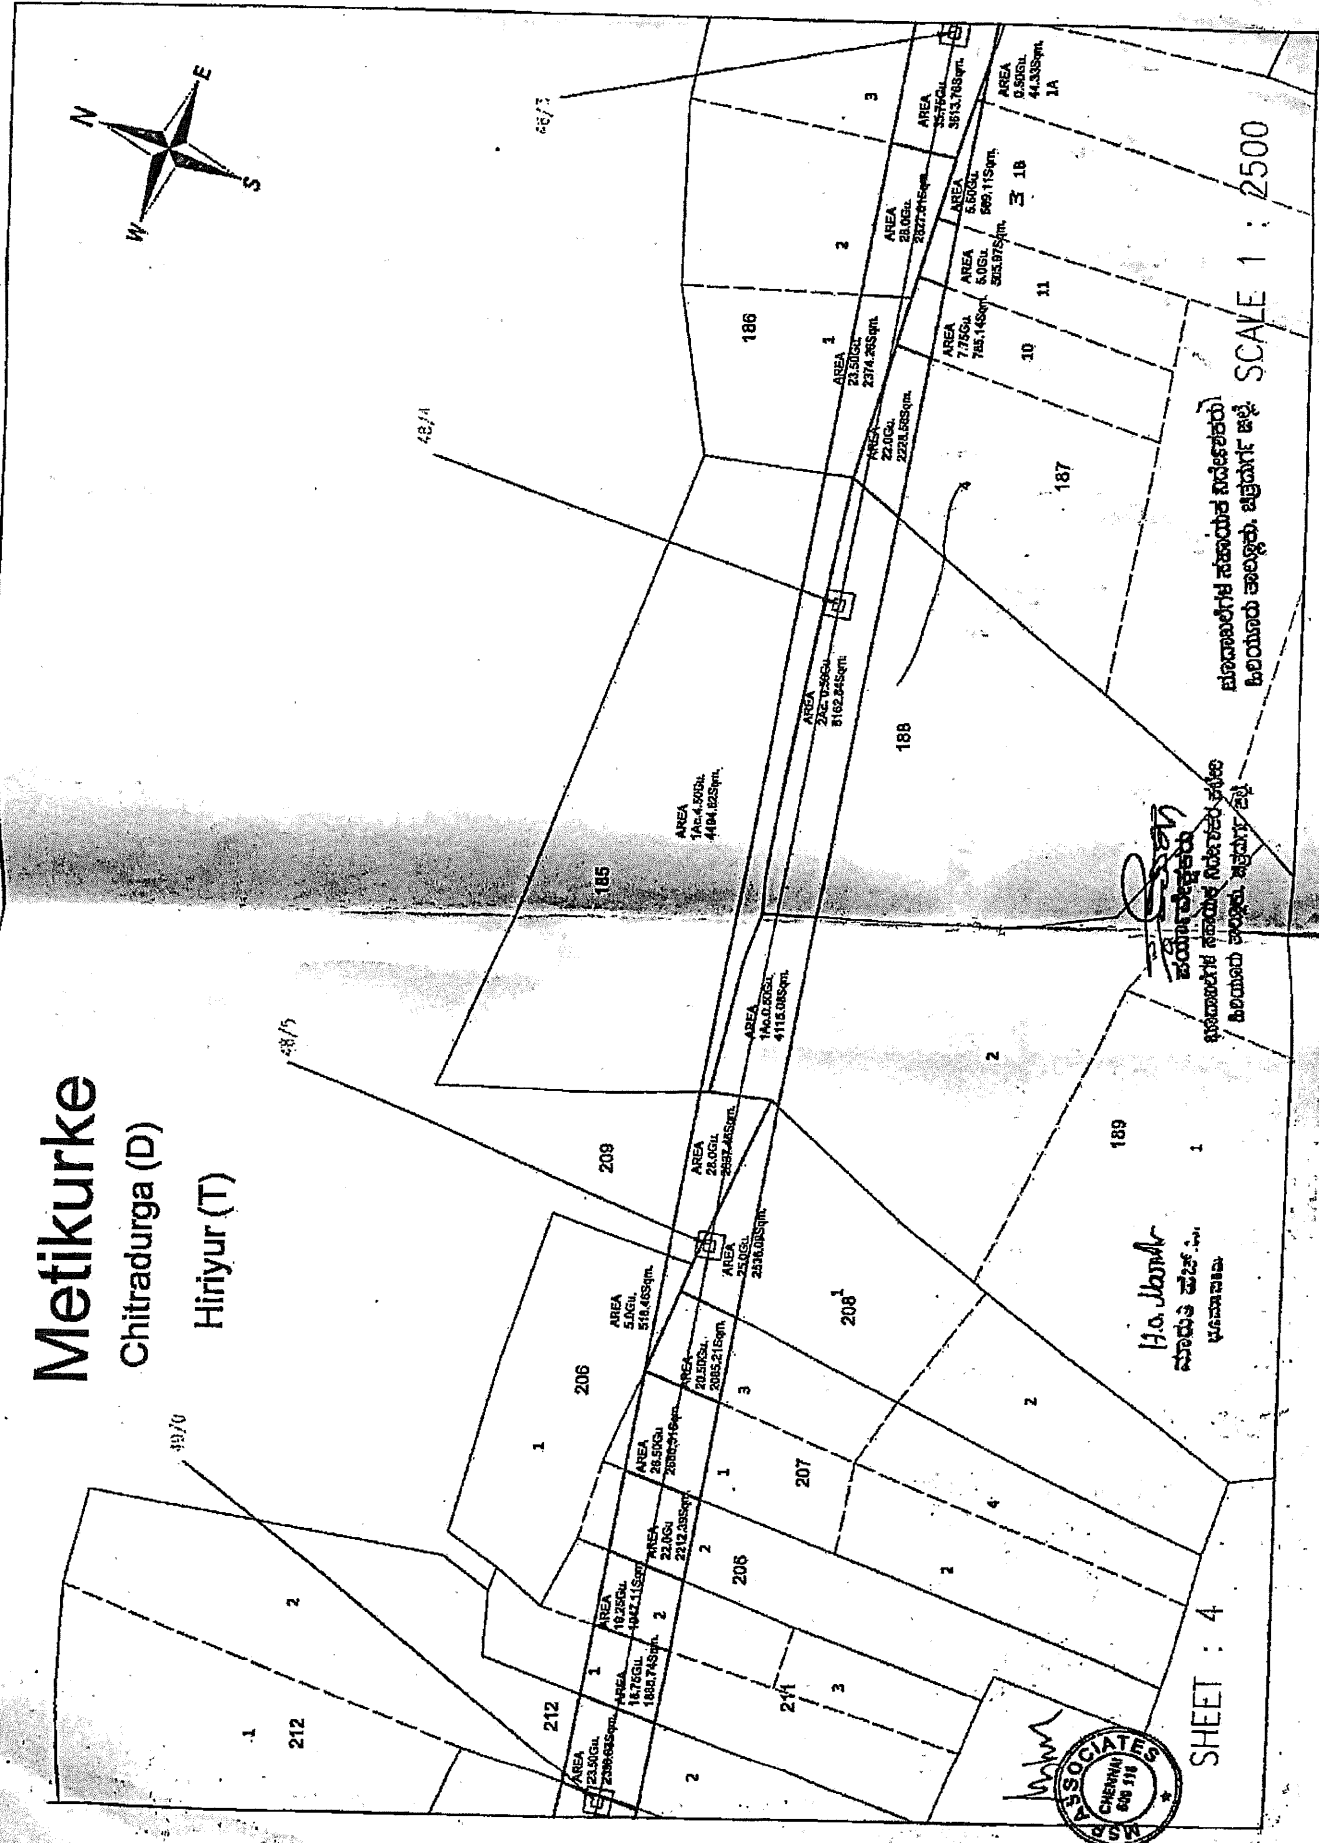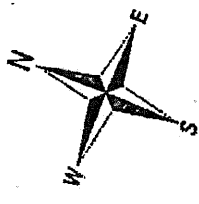

SCALE 1 : 2500

ಪುನಃಮಾಪನದ ನಡವಳಿಯಿಂದ
ಹಿರಿಯೂರು ತಾಲೂಕು, ಚಿತ್ರದುರ್ಗ ಜಿಲ್ಲೆ

ಪುನಃಮಾಪನದ ನಡವಳಿಯಿಂದ
ಹಿರಿಯೂರು ತಾಲೂಕು, ಚಿತ್ರದುರ್ಗ ಜಿಲ್ಲೆ

H. J. Jankar
ಮಾನ್ಯ ವಕೀಲರು
ಬಳ್ಳಾರಿ

SHEET : 4

