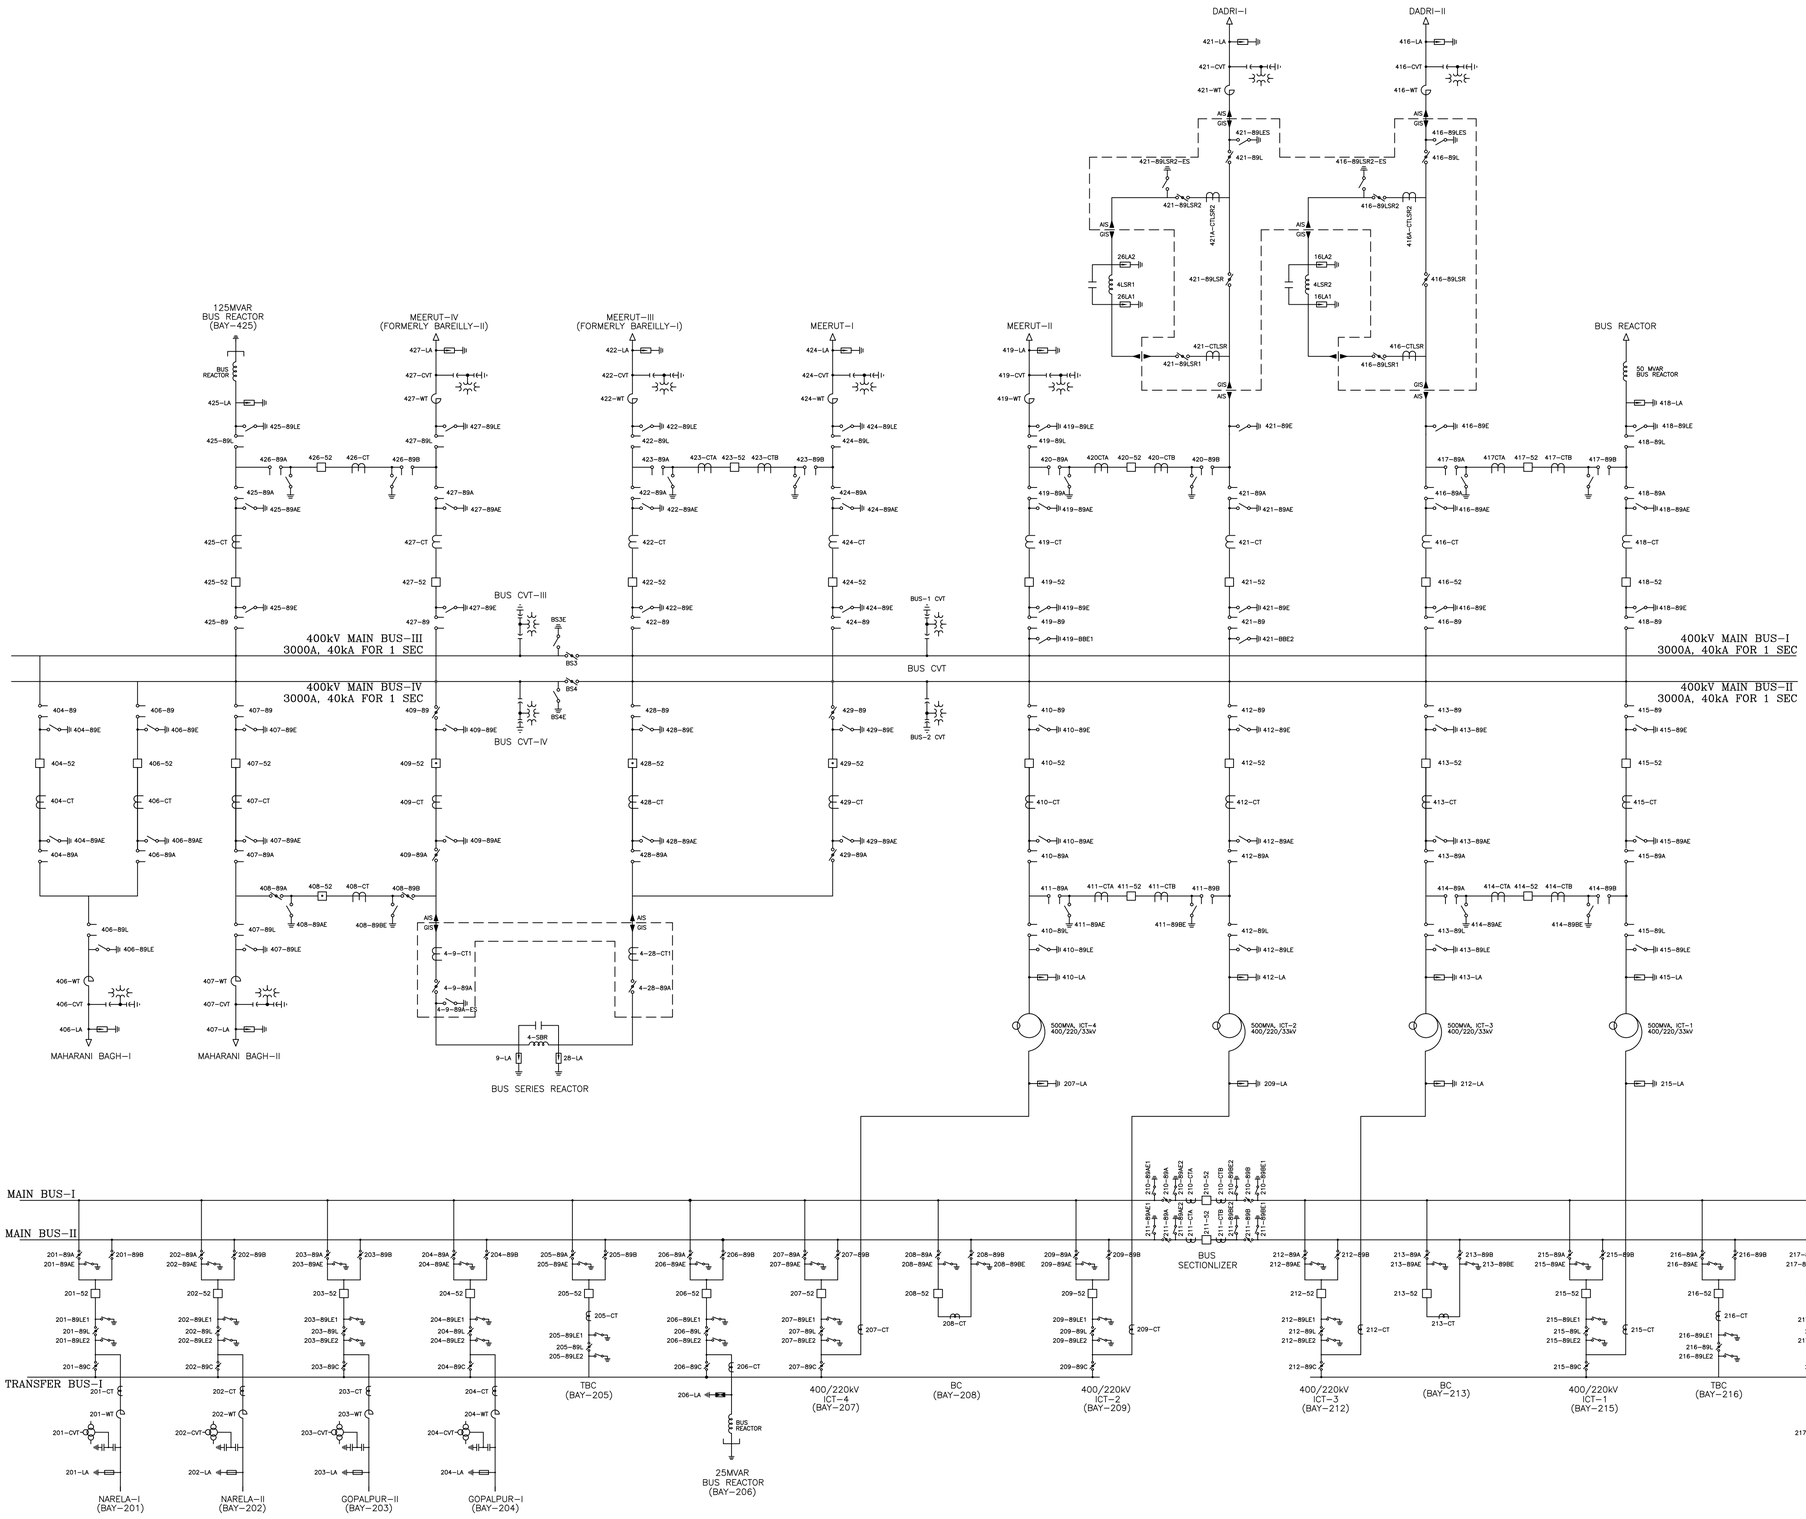

AS BUILT

CLIENT: भारत ग्रिड परियोजना का एक प्रभाग POWER GRID CORPORATION OF INDIA LIMITED. (A Government of India Enterprise)

2nd FLOOR, PLOT No.-2 SECTOR-29 GURGAON-122 001 (HARYANA).

PROJECT: SUBSTATION EXTENSION PACKAGE SS-26 (I) EXTENSION OF 400/220KV ROORKEE S/S, (II) EXTENSION OF 400/220KV SONNEPAT S/S, (III) EXTENSION OF 400/220KV BHADLA S/S, (IV) EXTENSION OF 400/220KV JIND S/S, (V) EXTENSION OF 400/220KV MANDOLA S/S, (VI) EXTENSION OF 400KV HISAR S/S, (VII) EXTENSION OF 400KV SIKAR S/S, (VIII) EXTENSION OF 400KV MEERUT S/S, AND (IX) EXTENSION OF 400/220KV SAHARANPUR S/S UNDER NORTHEN REGION STRENGTHENING SCHEME (NRSS) XL

LOA No.: CC-CS/906-NRI/SS-3928/3/GS/NOA-I/8908 DATED 03.10.2019
CC-CS/906-NRI/SS-3928/3/GS/NOA-II/8909 DATED 03.10.2019

TITLE: SINGLE LINE DIAGRAM OF 400/220kV MANDOLA

REV.No.	DESCRIPTION	DATE	DRAWN	REVIEW	ELE.	CIVIL	MECH.	APPROVED	STATUS
		Name							
		Date							
		Sign.							
		Name							
		Date							
		Sign.							
		Name							
		Date							
		Sign.							
		Name							
		Date							
		Sign.							
		Name	SS	SB	SJ			AD	
Z	AS BUILT	Date	12.10.21	12.10.21	12.10.21			12.10.21	
		Sign.							

CHECKED

A1

KPTL/F-7/831/ POWER TRANSMISSION LIMITED

KALPATARU POWER TRANSMISSION LIMITED B-6, 4TH FLOOR, TOWER-3 SECTOR-62, NOIDA, U.P

DRAWING No.	TOTAL SH.	SH.No.	REV.
	001	001	Z

This drawing and design is the property of KPTL and must not be copied or lent without prior permission in writing