AS BUILT

CLIENT:
2nd FLOOR, PLOT No.-2
SECTOR-29
GURGAON-122 001
(HARYANA)

PROJECT:
765/400kV SASARAM(NEW) SUBSTATION ASSOCIATED WITH 'COMMON SCHEME FOR 765kV POOLING STATION AND NETWORK FOR IR AND COMMON SCHEME FOR NETWORK FOR WR' AND EXTN. OF 765/400kV SASARAM SUBSTATION ASSOCIATED WITH 'SUPPLIMENTARY TRANSMISSION SYSTEM FOR PVC & MITHUN RIGHT BANK PROJECT' SEC. C-I/2210-S0104-3

LOA No.: C-I/2210-S0104-I/03/NOA-I/3383, NOA-II/3384 & NOA-III/3387 (DATED-29/06/2010)

TITLE:
LAYOUT PLAN & SECTION FOR 400kV SUBSTATION

REV.	DESCRIPTION	DRAWN	REVIEWED	CHECKED			APPROVED	STATUS
		DATE	ELE	CIVIL	MECH.			
0	FIRST ISSUE	Name	SBH	GSE	GSG	AP/D.SAL	PBK	FOR APPROVAL
		Date	13.09.10	13.09.10	13.09.10	13.09.10	13.09.10	
1	REVISED AS PER CUSTODIAN COMMENTS	Name	SBH	GSE	GSG	AP/D.SAL	PBK	CAT-II
		Date	03.12.10	03.12.10	03.12.10	03.12.10	03.12.10	
2	REVISED AS PER PGCIL COMMENTS DATED-17.10.10 & SITE VISIT DATED 05.01.11	Name	SBH	GSE	GSG	AP/D.SAL	PBK	FOR APPROVAL
		Date	11.01.11	11.01.11	11.01.11	11.01.11	11.01.11	
3	REVISED AS PER PGCIL COMMENTS DATED-17.01.11	Name	SSM	GSE	GSG	AP/D.SAL	PBK	CAT-II
		Date	25.01.11	25.01.11	25.01.11	25.01.11	25.01.11	
4	REVISED AS PER PGCIL COMMENTS DATED-09.02.11	Name	MOS	GSE	GSG	AP/D.SAL	PBK	FOR APPROVAL
		Date	09.02.11	09.02.11	09.02.11	09.02.11	09.02.11	
5	REVISED IN LINE WITH FOUNDATION LAYOUT	Name	MOS	GSE	GSG	AP/D.SAL	PBK	FOR APPROVAL
		Date	26.07.11	26.07.11	26.07.11	26.07.11	26.07.11	
6	AS BUILT	Name	VKV	DMH	DMH	ARD	SKP	AS BUILT
		Date	13.02.15	13.02.15	SSM			13.02.15

SNO.	DESCRIPTION	QUANTITY (FOR 31GAC-1) (SHT-1)
01	400kV BPI_BAY	33

BILL OF QUANTITY

NOTES:-

1. ALL THE DIMENSIONS ARE in MM.
2. * LOCATION OF WAVE TRAP SHOWN IS INDICATIVE ONLY. FINAL LOCATION SHALL BE DECIDED BASED ON PLCC REQUIREMENT.
3. ALL THE EQUIPMENT CONNECTION SHALL BE DONE BY AREVA.
4. DEAD END TOWER EXECTION AND OUTGOING SHIELD WIRE ARE NOT IN AREVA SCOPE
5. SUPPLY EXECTION, TESTING & COMMISSIONING OF TWO & HALTION INCLUDING (OLTC & TERMINAL CONNECTION OF TWO(1 NO. & 1 NO.) CONNECTION OF REACTOR) FOUNDATION
6. NOTE CONFIRM DIMENSION ARE PLANNED SO AS TO AVOID ACCIDENT IN THE REGARDLESS AND ESTENCH. CLEARANCE. HOWEVER IF ELECTRICAL CLEARANCE ARE NOT AVAILABLE AT SITE AND MODIFICATIONS ARE REQUIRED IN AGREE IT THE REQUIRED MODIFICATION
7. LOCATION OF LINE COUPLING SHOWN ARE INDICATIVE ONLY. FINAL LOCATION SHALL BE DONE BY AREVA WITHOUT ANY EXTRA COST IMPLICATION TO OWNER.
8. BOUNDARY WALL ALONG WITH SUBSTATION PROPERTY LINE, OWNER SITE OFFICE, STORES, CONTROLRING
9. FIRE RESISTANT WALL BETWEEN TWO TRANSFORMER UNITS ARE NOT IN AREVA SCOPE.
10. SOIL RESISTIVITY & SOIL RESISTANCE MEASUREMENT OF SUBSTATION AREA NOT IN AREVA SCOPE.
11. ALL CIVIL/STRUCTURAL DRAWING SHALL BE CHECKED AND ENDORSED BY SITE.
12. ROADS SHOWN OF ROAD WIDTH SHALL BE SHOWN IN ROAD LAYOUT.
13. ALL EQUIPMENT QTY. SHALL BE AS PER APPROVED SLD.
14. FOUNDATION FOR WAVE TRAP AND CVT IN ALL THREE PHASES.
15. IN BHARSAWAR-2 S/S, THERE IS UNDER GROUND 33kV CABLE FROM 400/220kV GT-3 TO STATION VMD. THE CONFIRM OF THE SAME SHALL BE DONE TO AVOID FOULING WITH EQUIPMENT FOUNDATIONS. BY W/S ARE/A OR PER W/M HOLD AT SITE.
16. NO SUSPENSION STRING REQUIRED FOR QUAD CONDUCTOR BELOW GANTRY.
17. EXISTING EQUIPMENT IN EXISTING BAYS ARE NOT SHOWN FOR CLARITY PURPOSE
18. FOR 765kV GT-1 INTERCONNECTION REQUIRED 400kV EQUIPMENT AND THERE BOQ REFER 765kV GT-1 BOQ.
19. TRANSMISSION LINE SIDE ISOLATOR STRING FOR LINE TRANSMISSION AT TAKE-OFF GANTRY IS IN SCOPE OF W/S AREVA
20. 3kV SPARE CT & VOP BY-PASS ISOLATOR ARE ADDED AS SCOPE OF W/S ARE/A. DETAIL ARRANGEMENT SHALL BE SHOWN AFTER ISSUE OF REACTOR GA DRAWING BY W/S ARE/A.
21. FOUNDATION FOR 420kV BUS REACTOR, 420kV LINE REACTOR ALONGWITH NGR, LA NOT & BY-PASS ISOLATOR, ROAD CUM BAY, TRACK & FENCE WALL ABOVE IS IN SCOPE OF W/S ARE/A.
22. LOCATION OF DEAD END TOWER IS TO BE CONFIRMED BY W/S POLE FOR BHARSAWAR-2&4 LINE.

SYSTEM PARAMETERS

SL.NO.	DESCRIPTION OF PARAMETER	400kV SYSTEM
1	SYSTEM OPERATING VOLTAGE	400kV
2	MAX. OPERATING VOLTAGE OF THE SYSTEM (rms)	420kV
3	RATED FREQUENCY	50Hz
4	NO. OF PHASES	3
5	RATED ISOLATION LEVELS i) FULL WAVE IMPULSE WITHSTAND VOLTAGE (1.2/50us-rms) ii) SWITCHING IMPULSE WITHSTAND VOLTAGE (250/2500us-rms) iii) ONE MINUTE POWER FREQUENCY DRY & WET WITHSTAND VOLTAGE (rms)	1550kVp 1050kVp 630kV
6	CREPAH CREEPAGE DISTANCE	32mm
7	MAX. RADIO INTERFERENCE VOLTAGE FOR FREQUENCY BETWEEN 0.5MHz & 2MHz AT 320kV AND FOR 400kV SYSTEM & 765kV AND FOR 320kV SYSTEM	1000 microV
8	MAX. CREEPAGE DISTANCE	25mm/kV (10500MM)
9	MAX. CLEARANCE i) PHASE TO PHASE ii) CONDUCTOR TO BOD iii) CONDUCTOR TO CONDUCTOR i) PHASE TO EARTH ii) CONDUCTOR TO EARTH iii) TECHNICAL CLEARANCE	4200MM 4200MM 4000MM 3500MM 3500MM 4000MM
10	GROUND CLEARANCE GROUND CLEARANCETROM BOTTOM OF PORCELAIN	8000MM 24400MM
11	RATED SHORT CIRCUIT CURRENT FOR 1 SEC DURATION	40kA
12	SYSTEM NEUTRAL EARTHING	EFFECTIVELY EARTHED

SWITCHYARD CONDUCTOR DETAILS

DESCRIPTION	400kV
MAIN BUS-I & II	QUAD ACSR BISMUS/WOOSE CONDUCTOR
EQUIPMENT INTERCONNECTION (Out-1=2km, Out-2=1.6km)	4" IPS AL. TUBE WOOSE ACSR CONDUCTOR
JUMPERS	WOOSE ACSR CONDUCTOR
DROPPERS	WOOSE ACSR CONDUCTOR
EARTHWIRE	7/3.66mm Gi WIRE (10.98mm DIA)

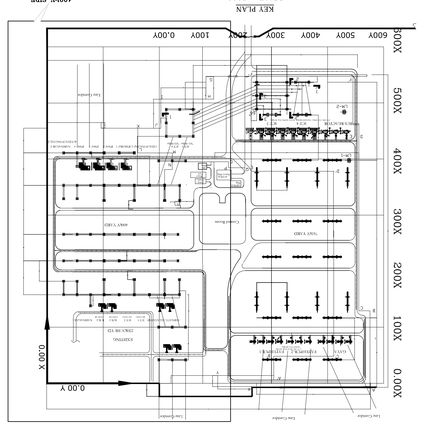

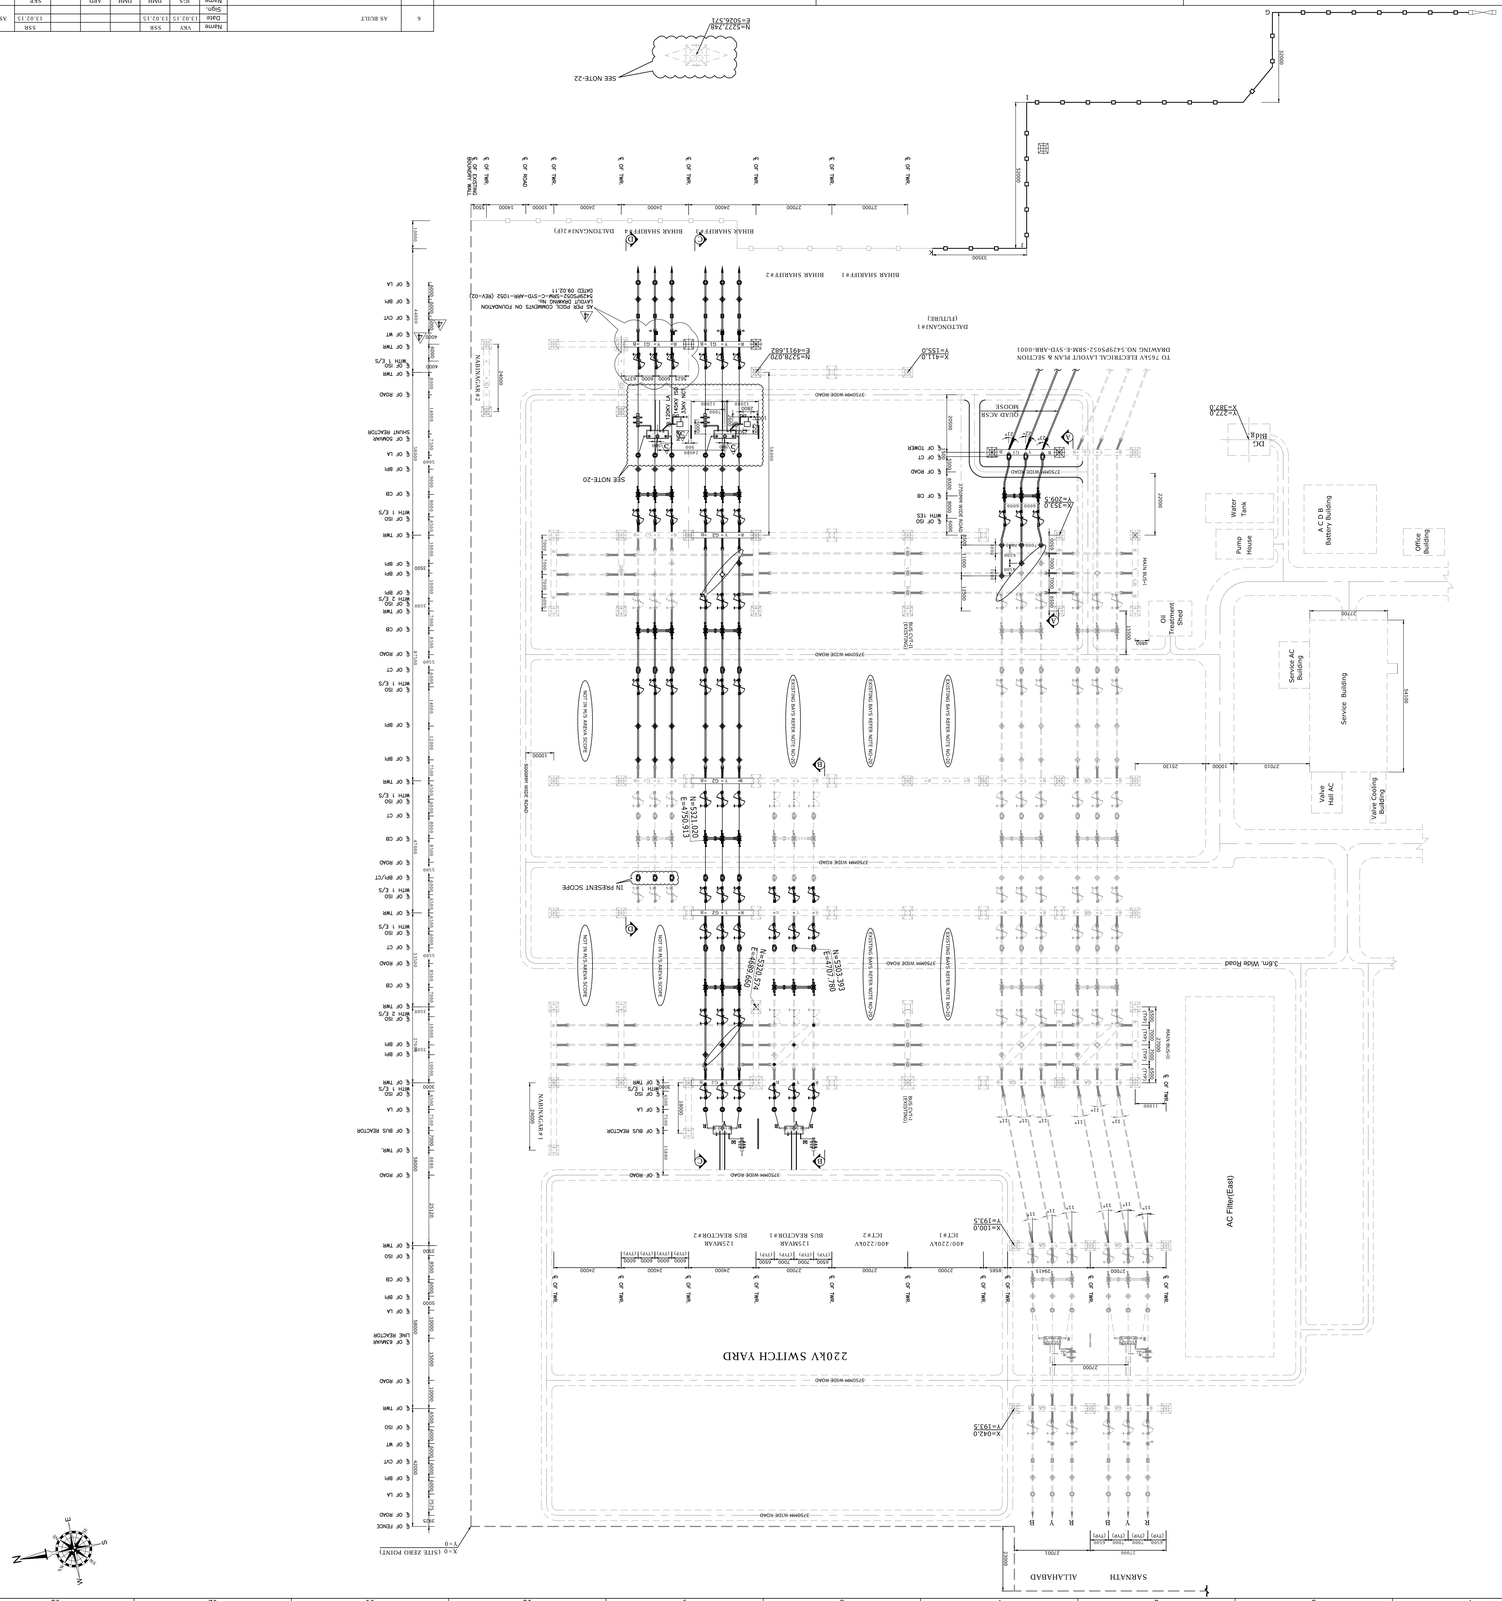
220kV SWITCH YARD
AC Filter(East)
SARATH
ALLAHABAD
3.0m. Wide Road
Service Building
Service AC Building
Valve Hall AC
Valve Cooling Building
Pump House
Water Tank
A C D B Battery Building
Office Building
Oil Treatment Shed
MAIN GATE
GUARD ACSR MOOSE
DATA TOWER
BUS REACTOR
BUS SECTION
400/220kV ICT#1
400/220kV ICT#2
125MVAR BUS REACTOR#1
125MVAR BUS REACTOR#2
N=5227.240
E=5026.571
SEE NOTE-22
N=5229.020
E=6911.682
SEE NOTE-20
N=5310.300
E=4150.913
N=5303.356
E=4107.780
N=5230.574
E=4480.240
X=1355.0
Y=227.0
X=305.3
Y=310.0
X=100.0
Y=193.0
X=642.0
Y=193.0
X=38.0
Y=227.0
TO 765kV ELECTRICAL LAYOUT PLAN & SECTION DRAWING NO.5429PS052-SRM-E-SYD-ARR-0001
(4 NOS.)
4L 400 POOL COMPONENTS ON FOUNDATION DRAWING NO. 5429PS052-SRM-E-SYD-ARR-1023 (REV-02) DATED 09.02.11
IN PRESENT SCOPE
WID IN/OUT ARE/A SCOPE
WID IN/OUT ARE/A SCOPE
